



K&E 151135 6-81 MC 2677

F.H.W.A. REGION NO.	STATE	FED. AID PROJ. NO.	SHEET NO.	TOTAL SHEETS
3	MD.			

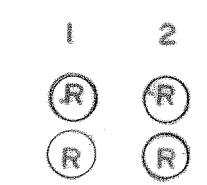

SPAN	DOWN	OUT	OUT
SPAN	UP	FL/R	FL/R

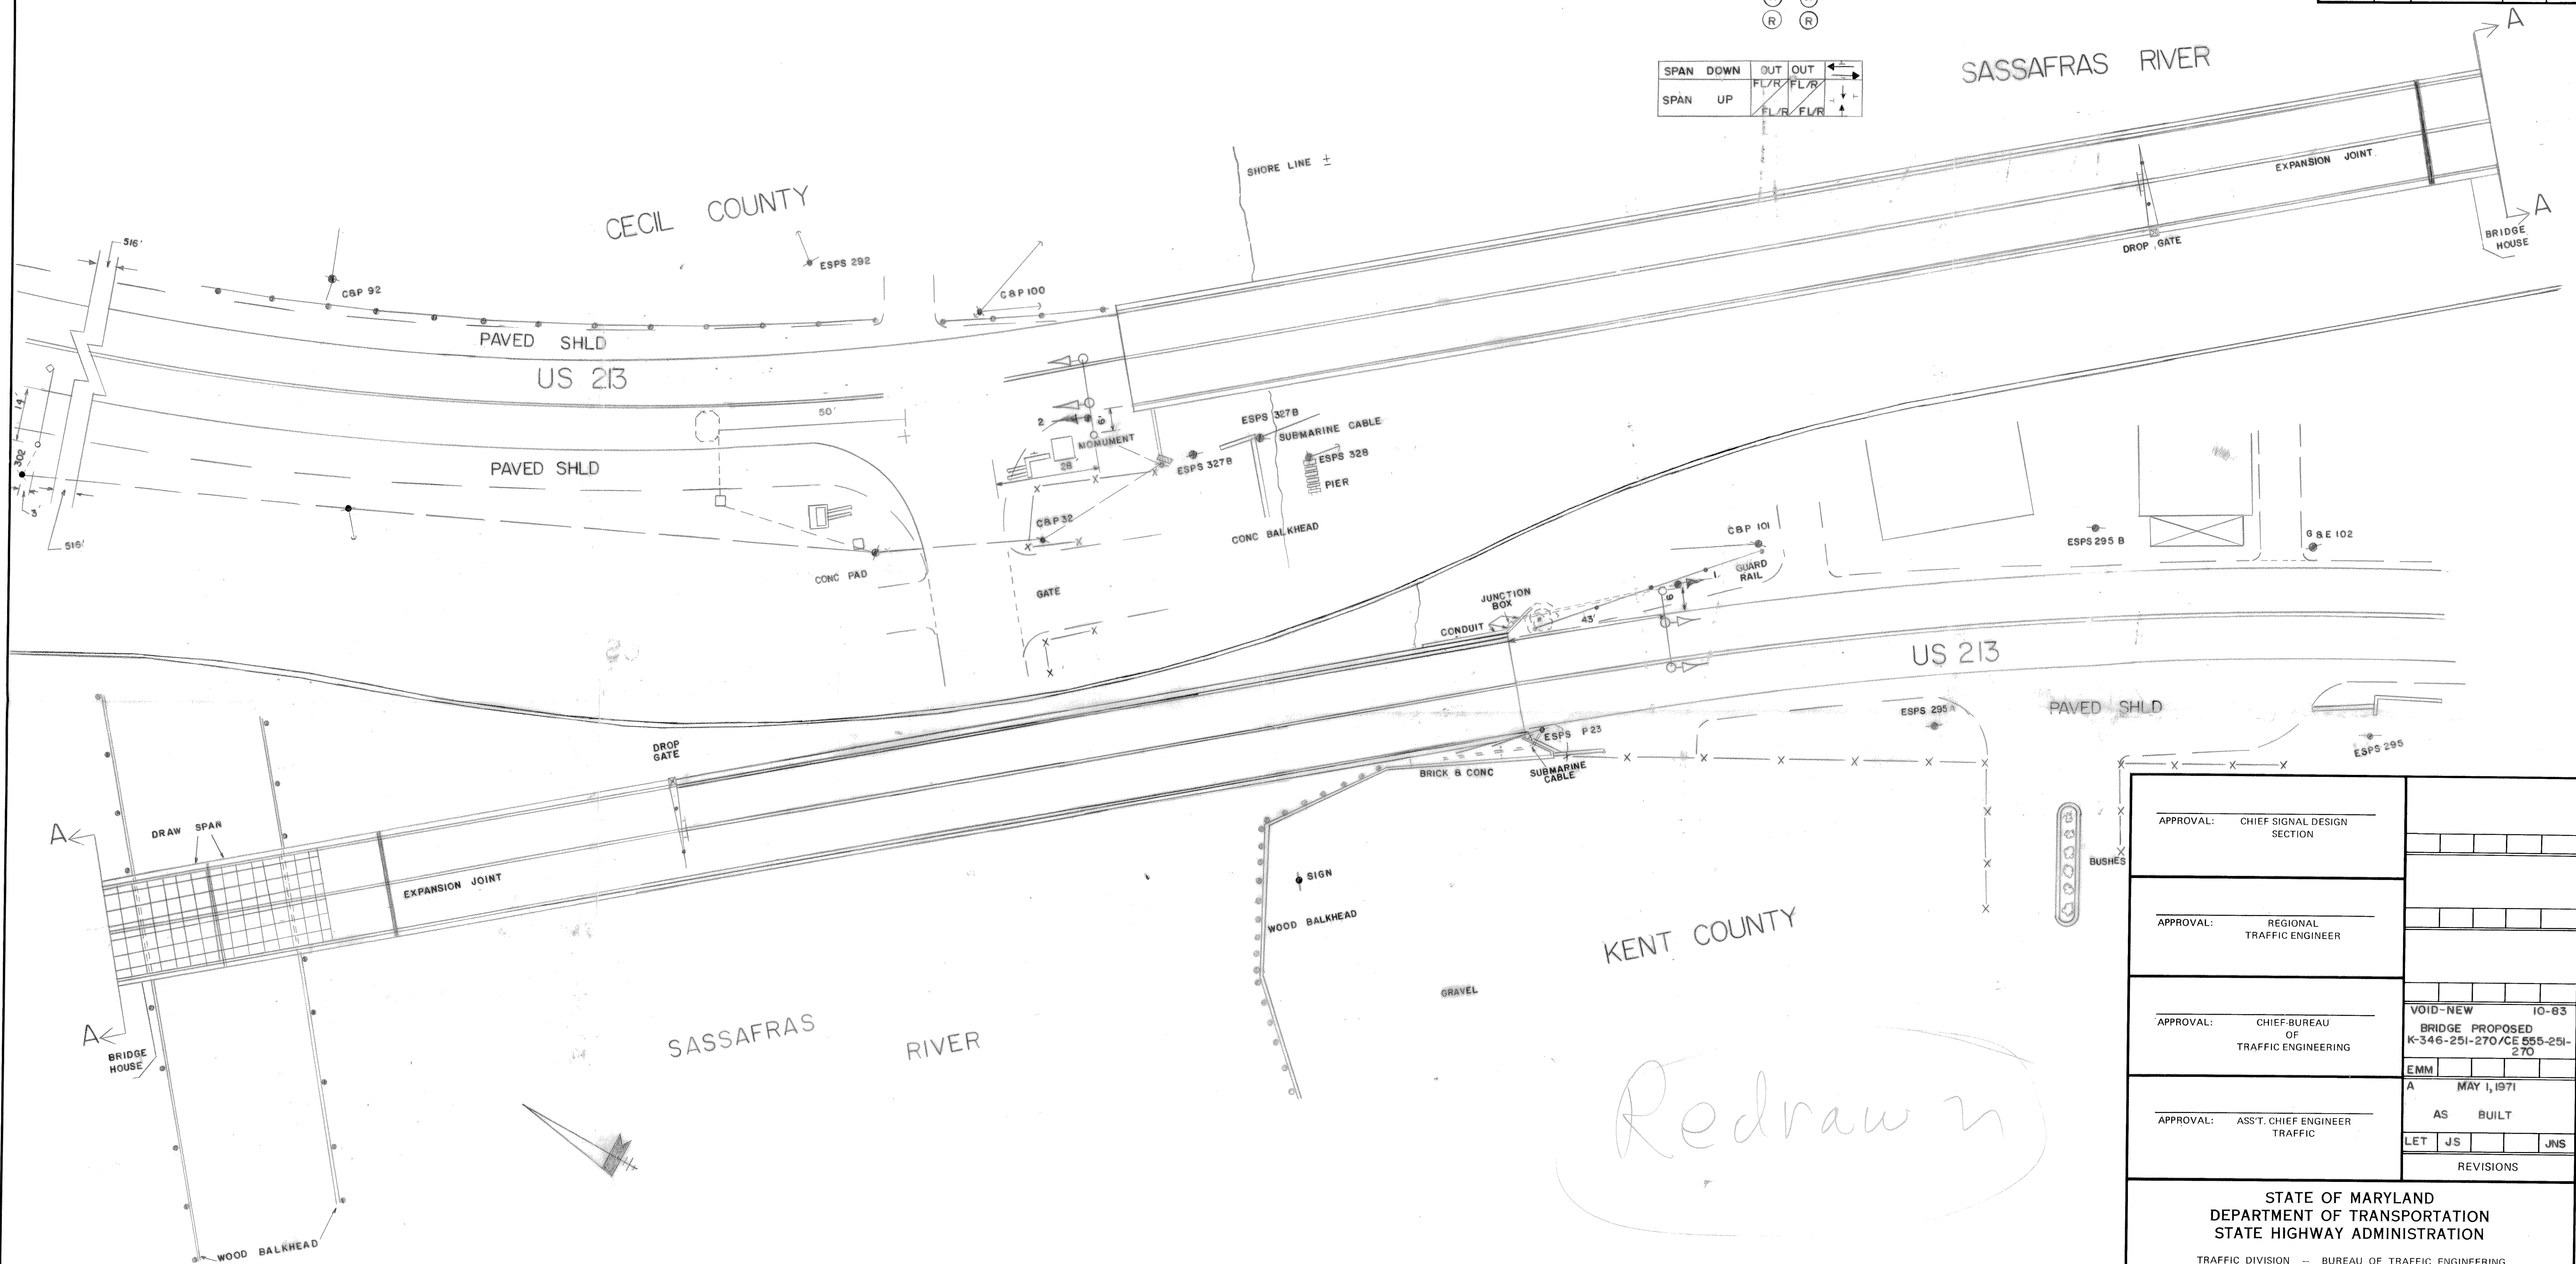

Redrawn

APPROVAL: CHIEF SIGNAL DESIGN SECTION	
APPROVAL: REGIONAL TRAFFIC ENGINEER	
APPROVAL: CHIEF-BUREAU OF TRAFFIC ENGINEERING	VOID-NEW 10-83 BRIDGE PROPOSED K-346-251-270/CE 555-251-270
APPROVAL: ASST. CHIEF ENGINEER TRAFFIC	EMM MAY 1, 1971 AS BUILT LET J/S JNS
REVISIONS	

STATE OF MARYLAND
DEPARTMENT OF TRANSPORTATION
STATE HIGHWAY ADMINISTRATION
TRAFFIC DIVISION — BUREAU OF TRAFFIC ENGINEERING

US 213 & GEORGETOWN BRIDGE

SCALE 1"=20' DATE MAY 1, 1971 CONTRACT NO.

DRAWN BY: LES TOWNSEND COUNTY: KENT & CECIL COUNTY

DESIGNED BY: SIGNAL NO.:

CHECKED BY: DRAWING NO. TS-344 A